



1/31

RECEIVED

DEC 03 2002

Technology Center 2100

Red line Version

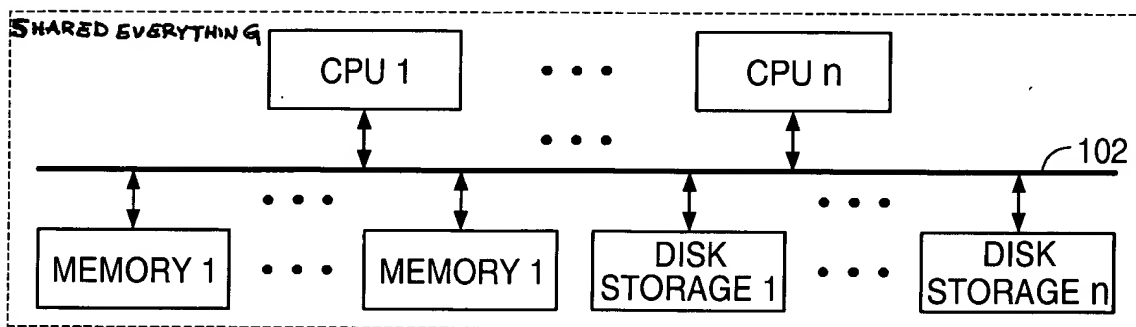


FIG. 1A  
(Prior Art)

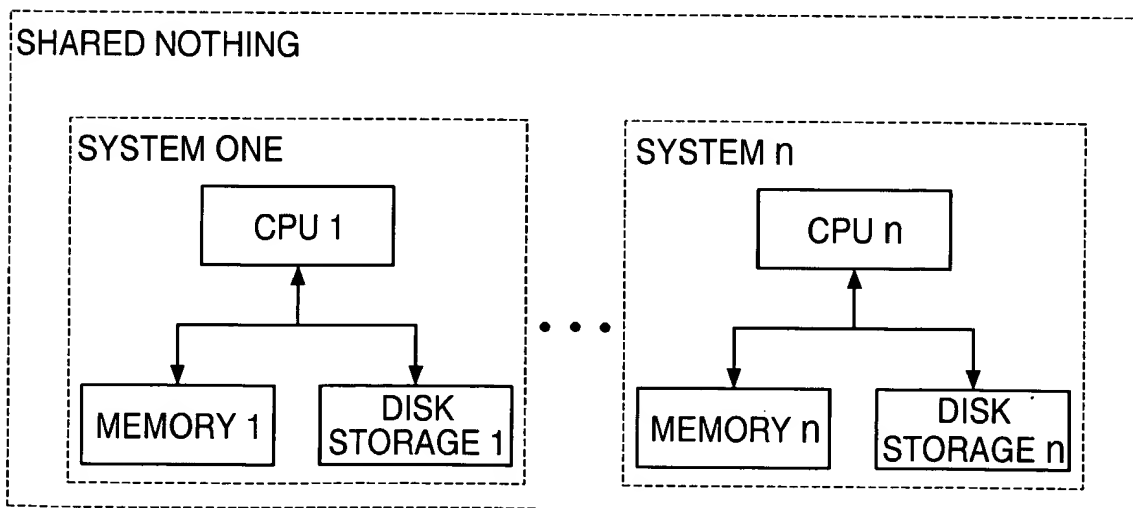


FIG. 1B  
(Prior Art)



RECEIVED

DEC 03 2002

Technology Center 2100

Red line Version

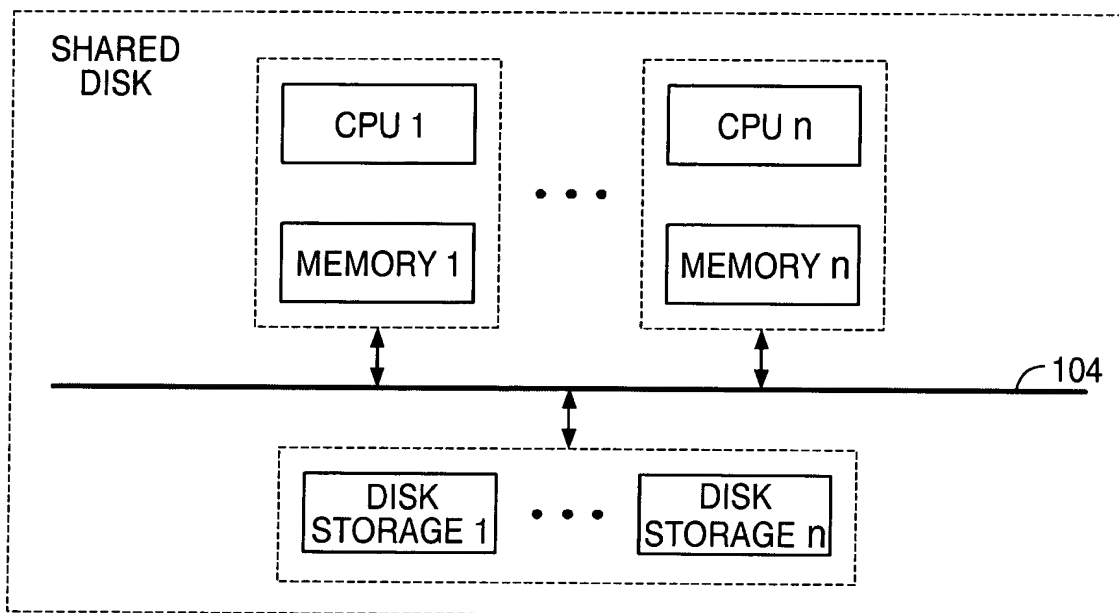


FIG. 1C  
(Prior Art)



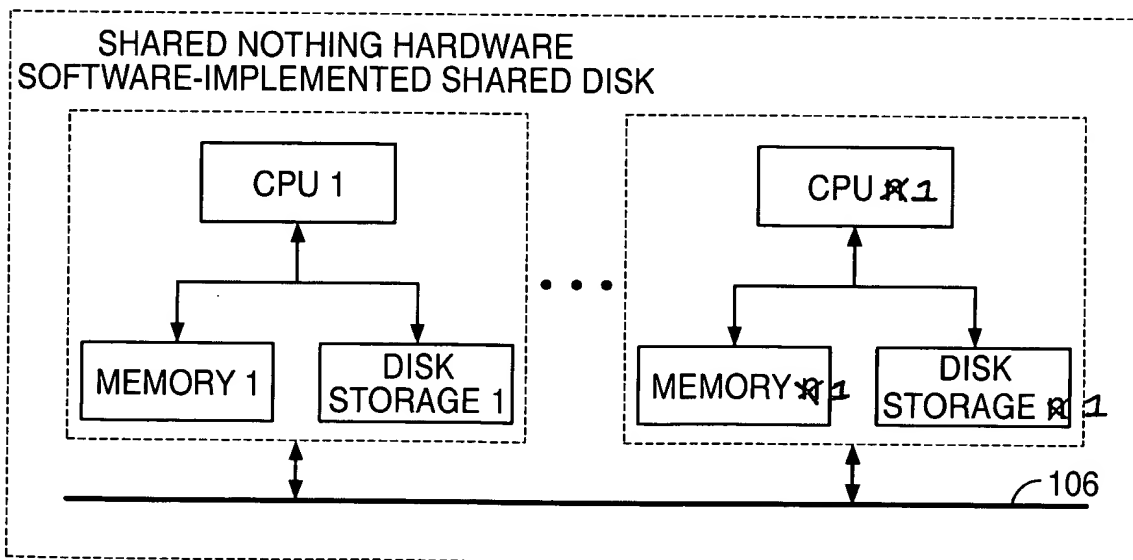


FIG. 1D  
(Prior Art)

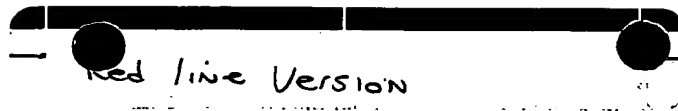

3/31

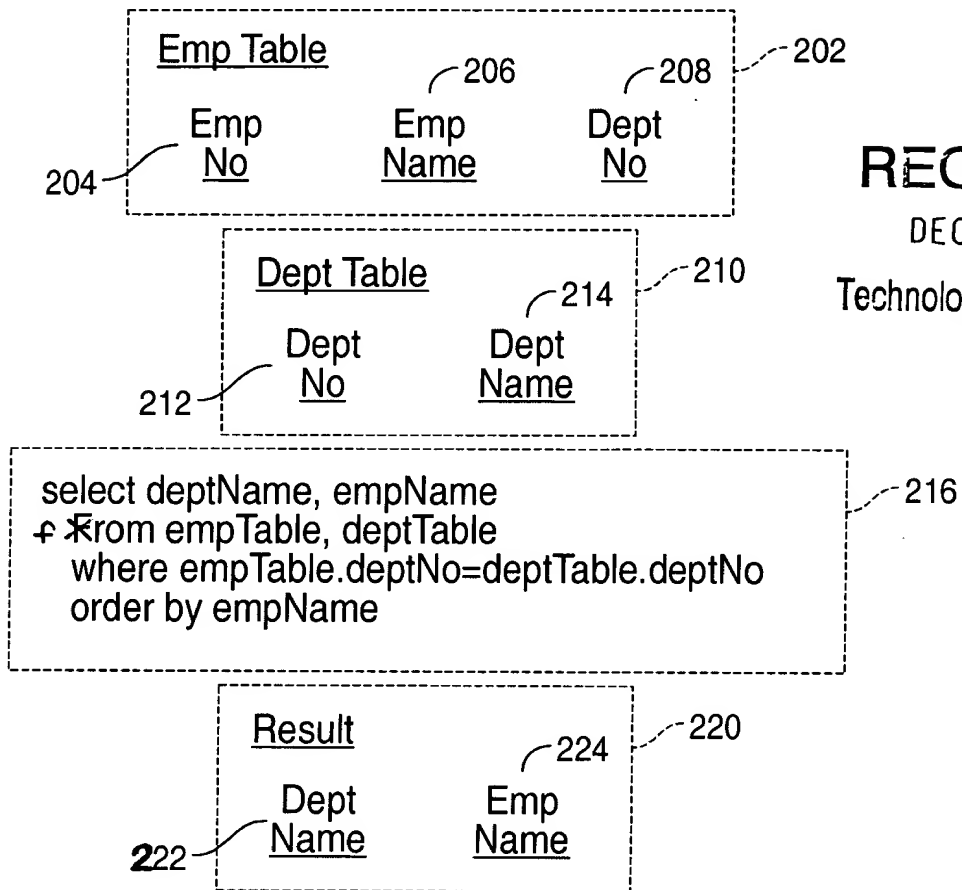

RECEIVED

DEC 03 2002

Technology Center 2100

FIG. 2

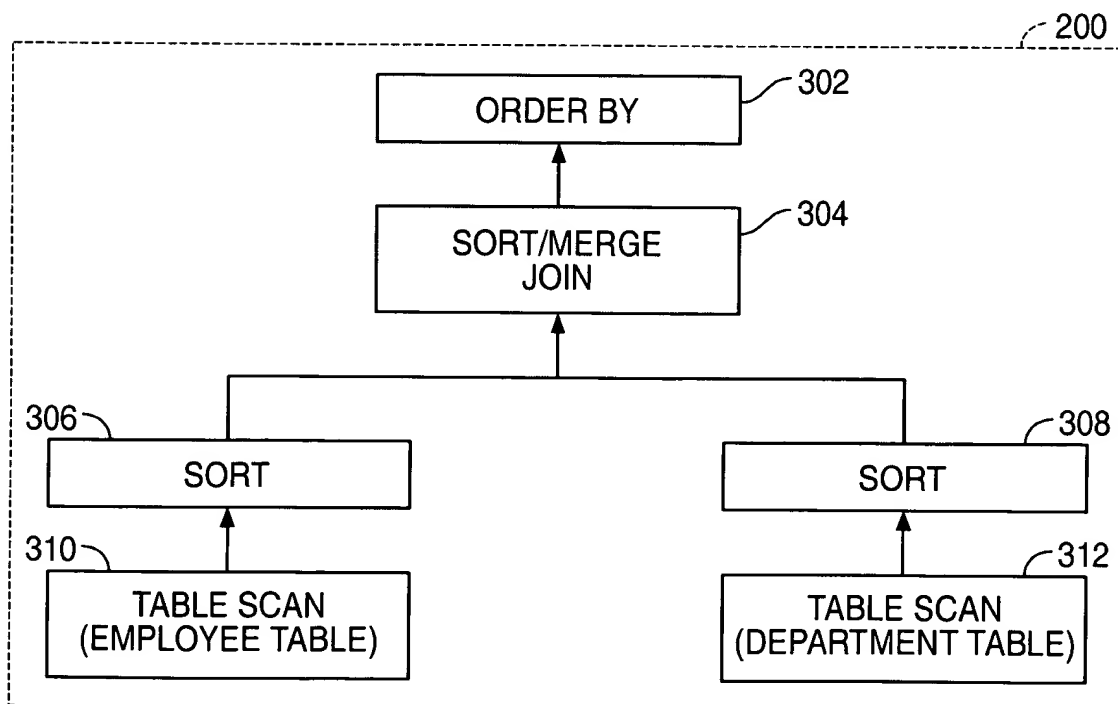


FIG. 3A

16/31

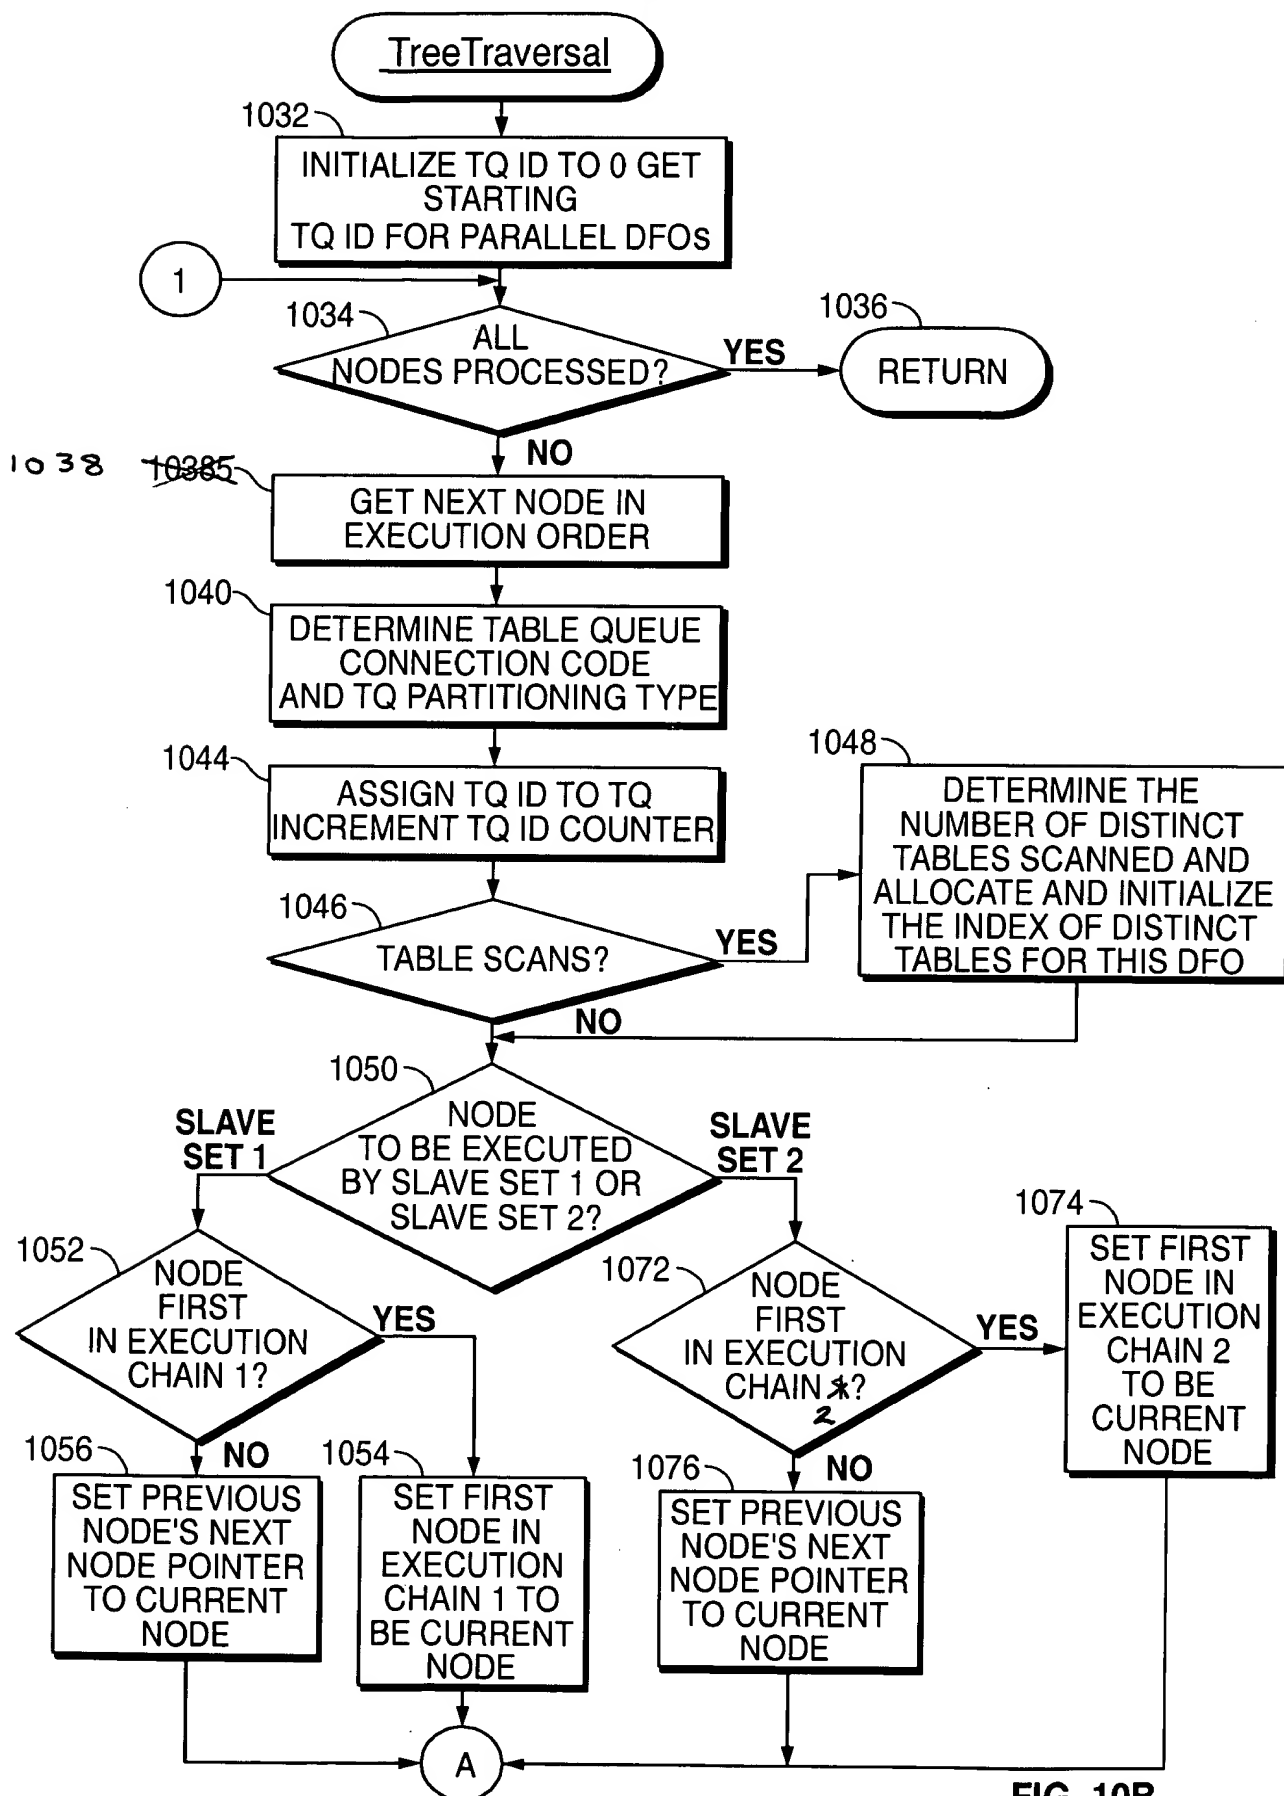


FIG. 10B

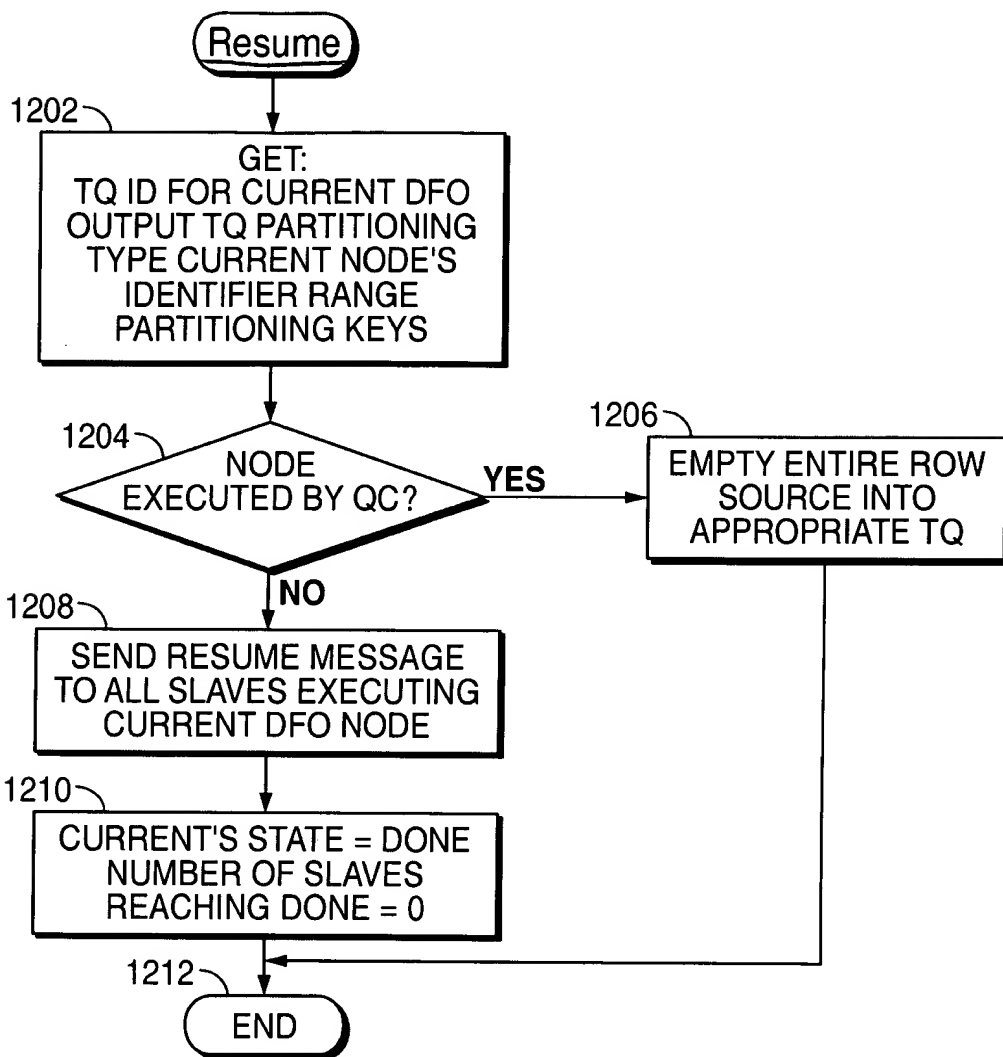


FIG. 12



27/31

Red line Version

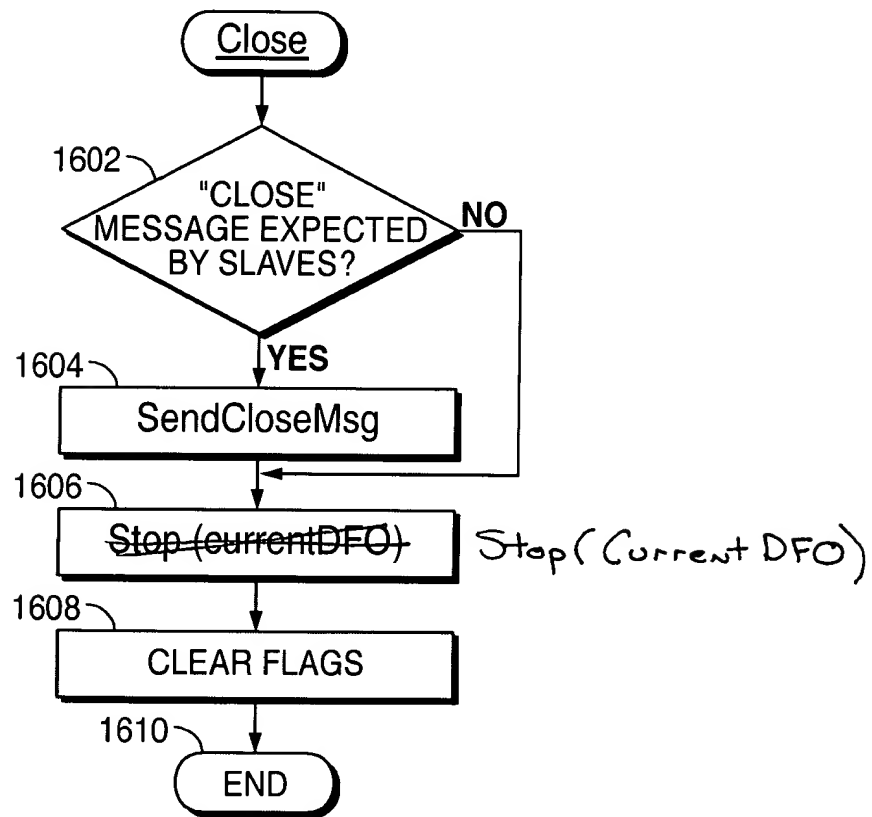


FIG. 16



31/31

Red line Version

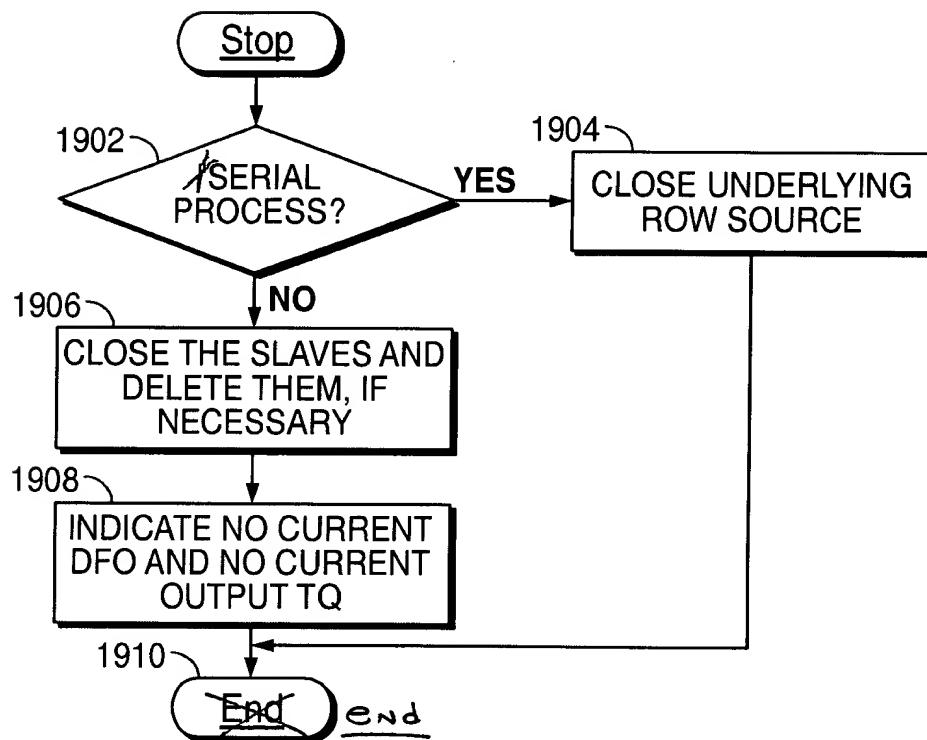


FIG. 19